



SUITE 450
AS BUILT - 1 OF 1
CULLMAN PARK - LEVEL FOUR
2,440 USF / 2,830 RSF
SCALE: NOT TO SCALE
DATE: MARCH 19, 2020

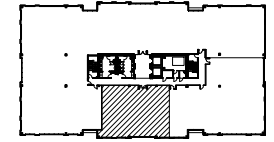

KEY PLAN

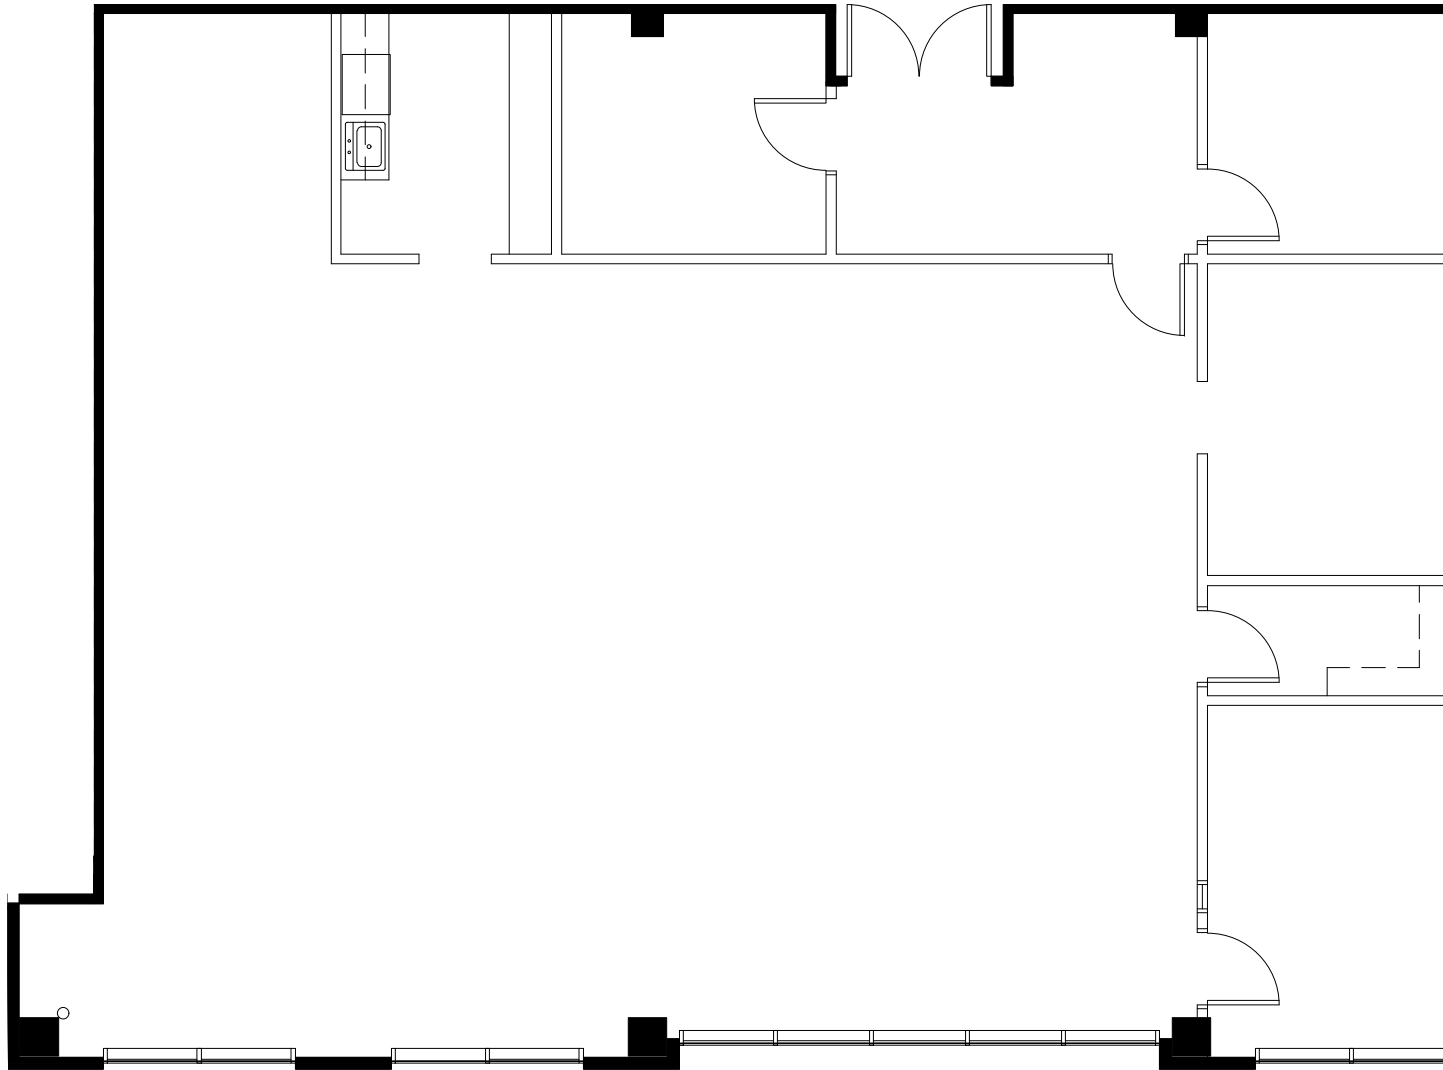

NORTHWOOD
OFFICE



**SMITH
HARRIS**
DESIGN
associates