




SUITE 350
AS BUILT - 1 OF 1
IRBY BUILDING - LEVEL THREE
4,765 USF / 5,527 RSF
SCALE: 3/32" = 1'-0"
DATE: MARCH 30, 2020

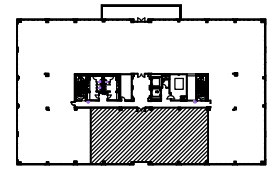

KEY PLAN

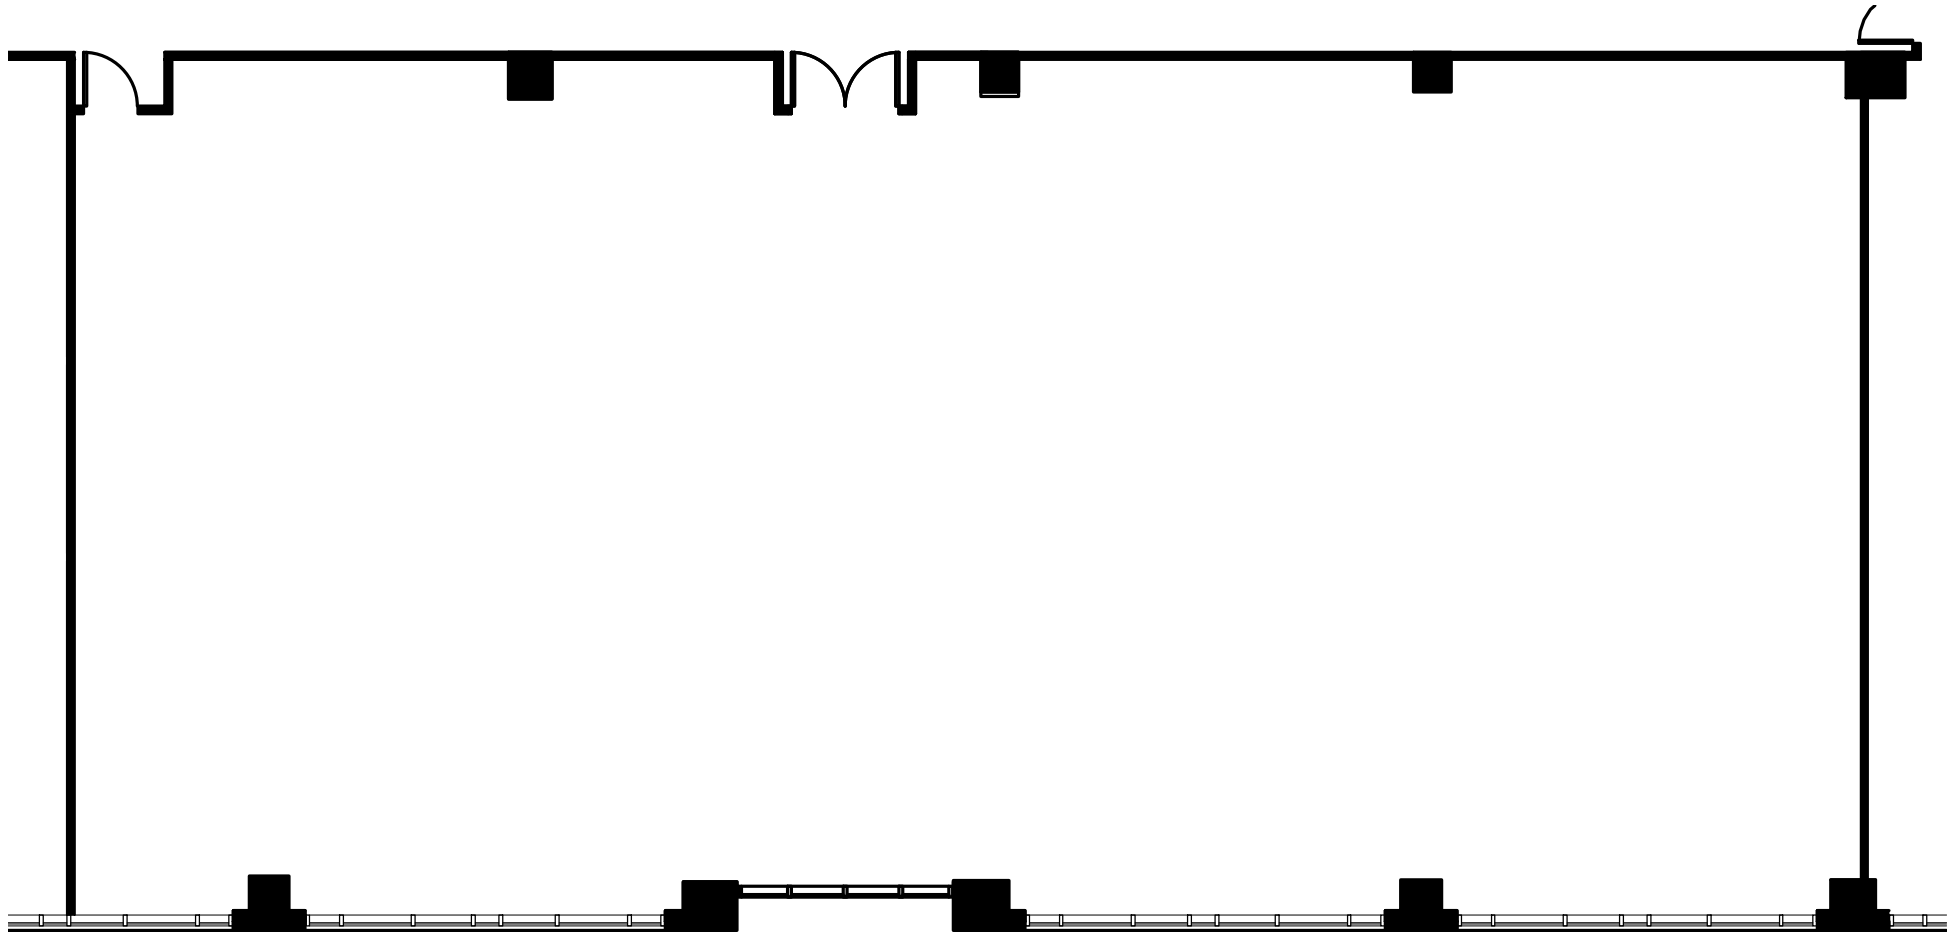

NORTHWOOD
OFFICE

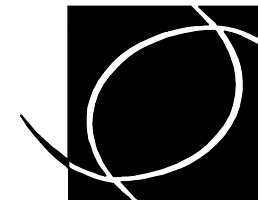

**SMITH
HARRIS**
DESIGN
associates