


SUITE 160
AS BUILT - 1 OF 1
CHANDLER BUILDING - LEVEL ONE
2,644 USF / 3,067 RSF
SCALE: 3/32" = 1'-0"
DATE: MAY 28, 2020

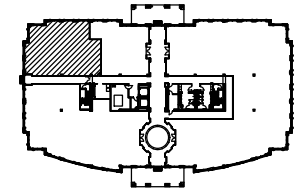

KEY PLAN

