


SUITE 200
 AS BUILT - 1 OF 1
 CORPORATE VILLA F - LEVEL TWO
 3,418 RSF
 NOT TO SCALE
 DATE: FEBRUARY 9, 2021

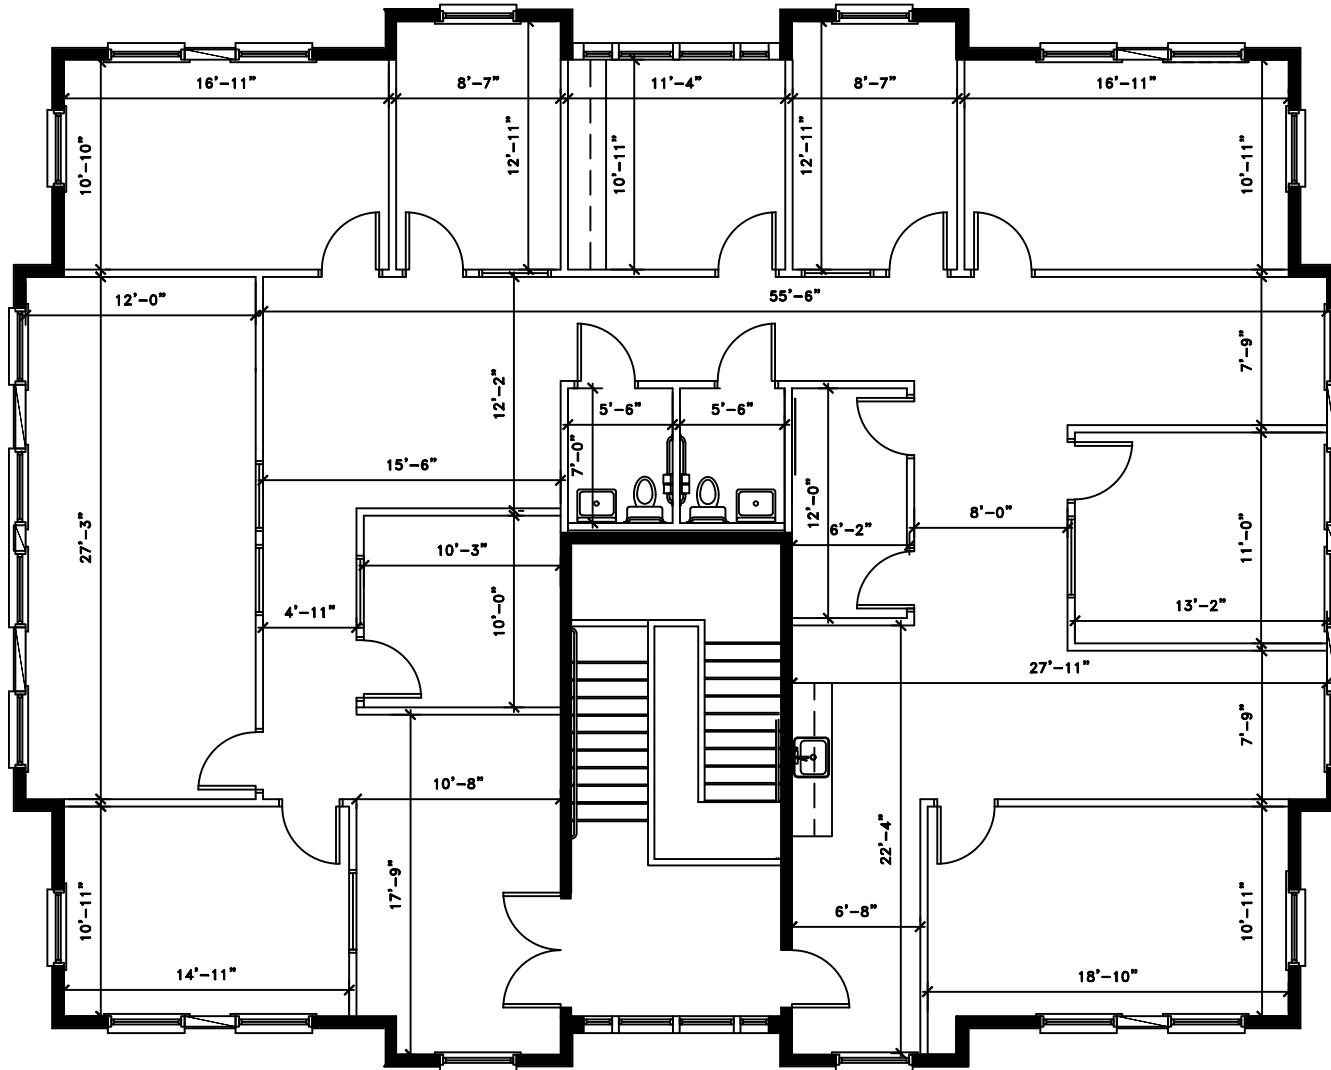

| SUMMARY | |
|---------|----------------|
| 1 | RECEPTION |
| 8 | PRIVATE OFFICE |
| 1 | IT ROOM |
| 2 | RESTROOMS |
| 1 | WORK ROOM |
| 1 | CONFERENCE |
| 3 | OPEN AREAS |
| 1 | BREAK |