


SUITE 200
3,090 RSF

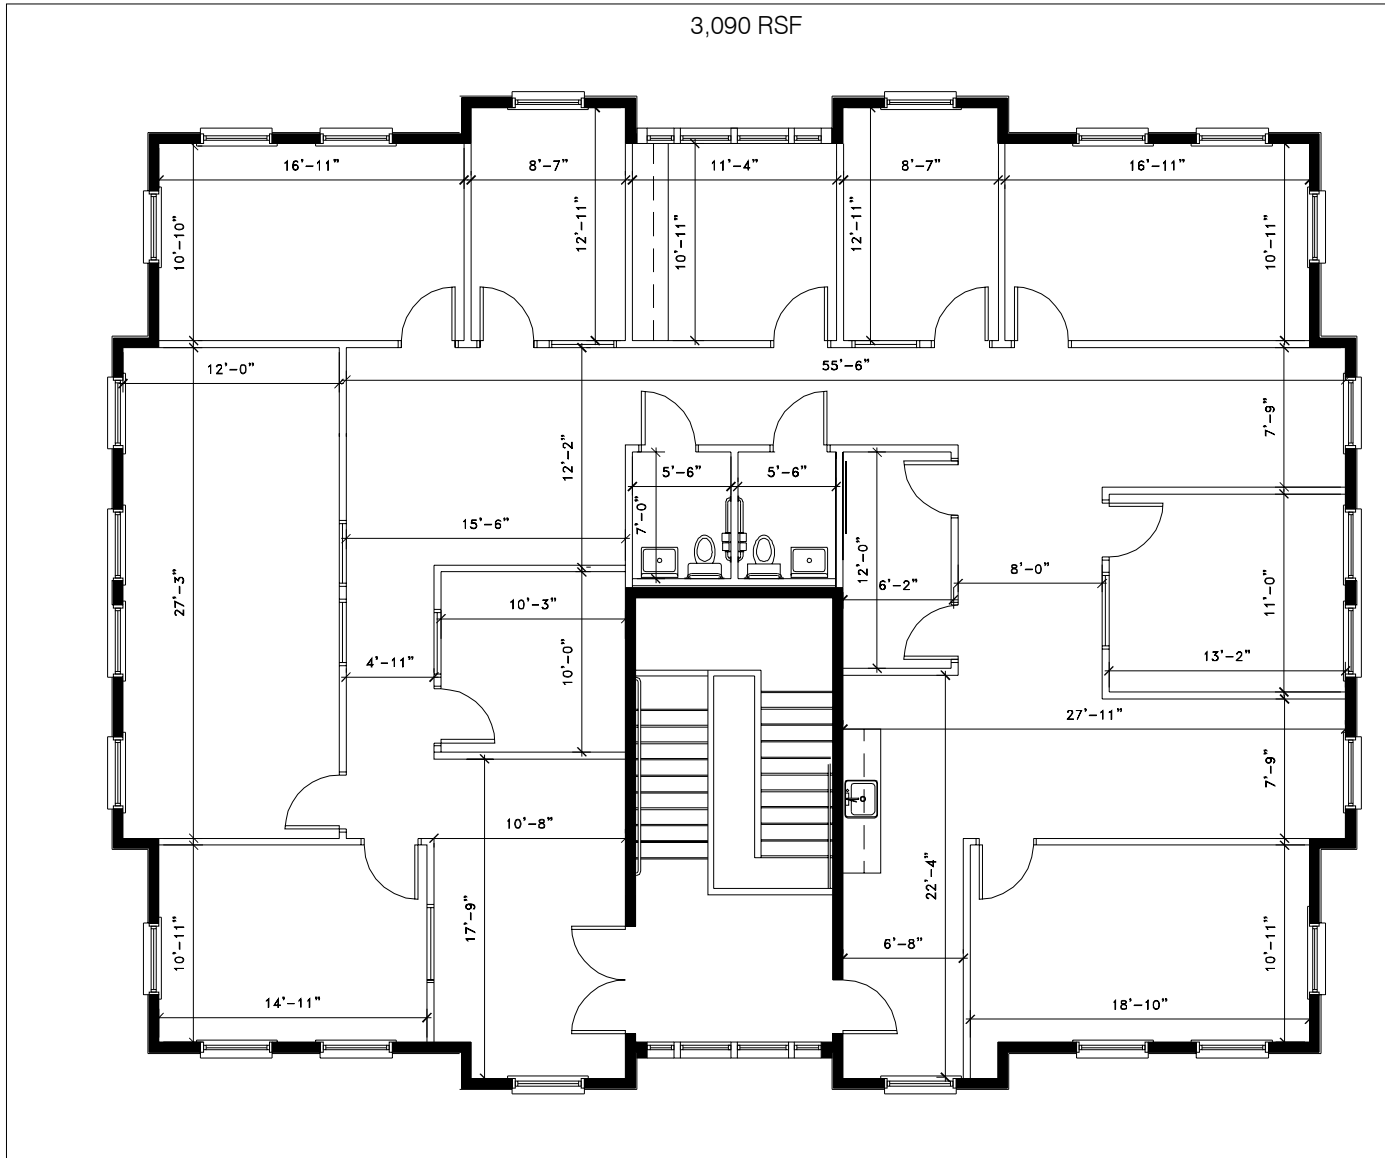

Offices
On Six

North Community
House Road

Building F

Level
Two

As Built

11-19-2020

Not to Scale

NORTHWOOD
OFFICES



**SMITH
HARRIS**
DESIGN
associates

SUMMARY

- 1 RECEPTION
- 1 CONFERENCE ROOM
- 8 OFFICES
- 3 SMALL OPEN AREAS
- 1 COPY/WORK
- 1 GALLEY
- 2 RESTROOMS
- 1 IT/STORAGE