


SUITE 425
 AS-BUILT - 1 OF 1
 HARRIS BUILDING
 3,123 USF / 3,623 RSF
 SCALE: 3/32" = 1'-0"
 DATE: DECEMBER 3, 2020



KEY PLAN

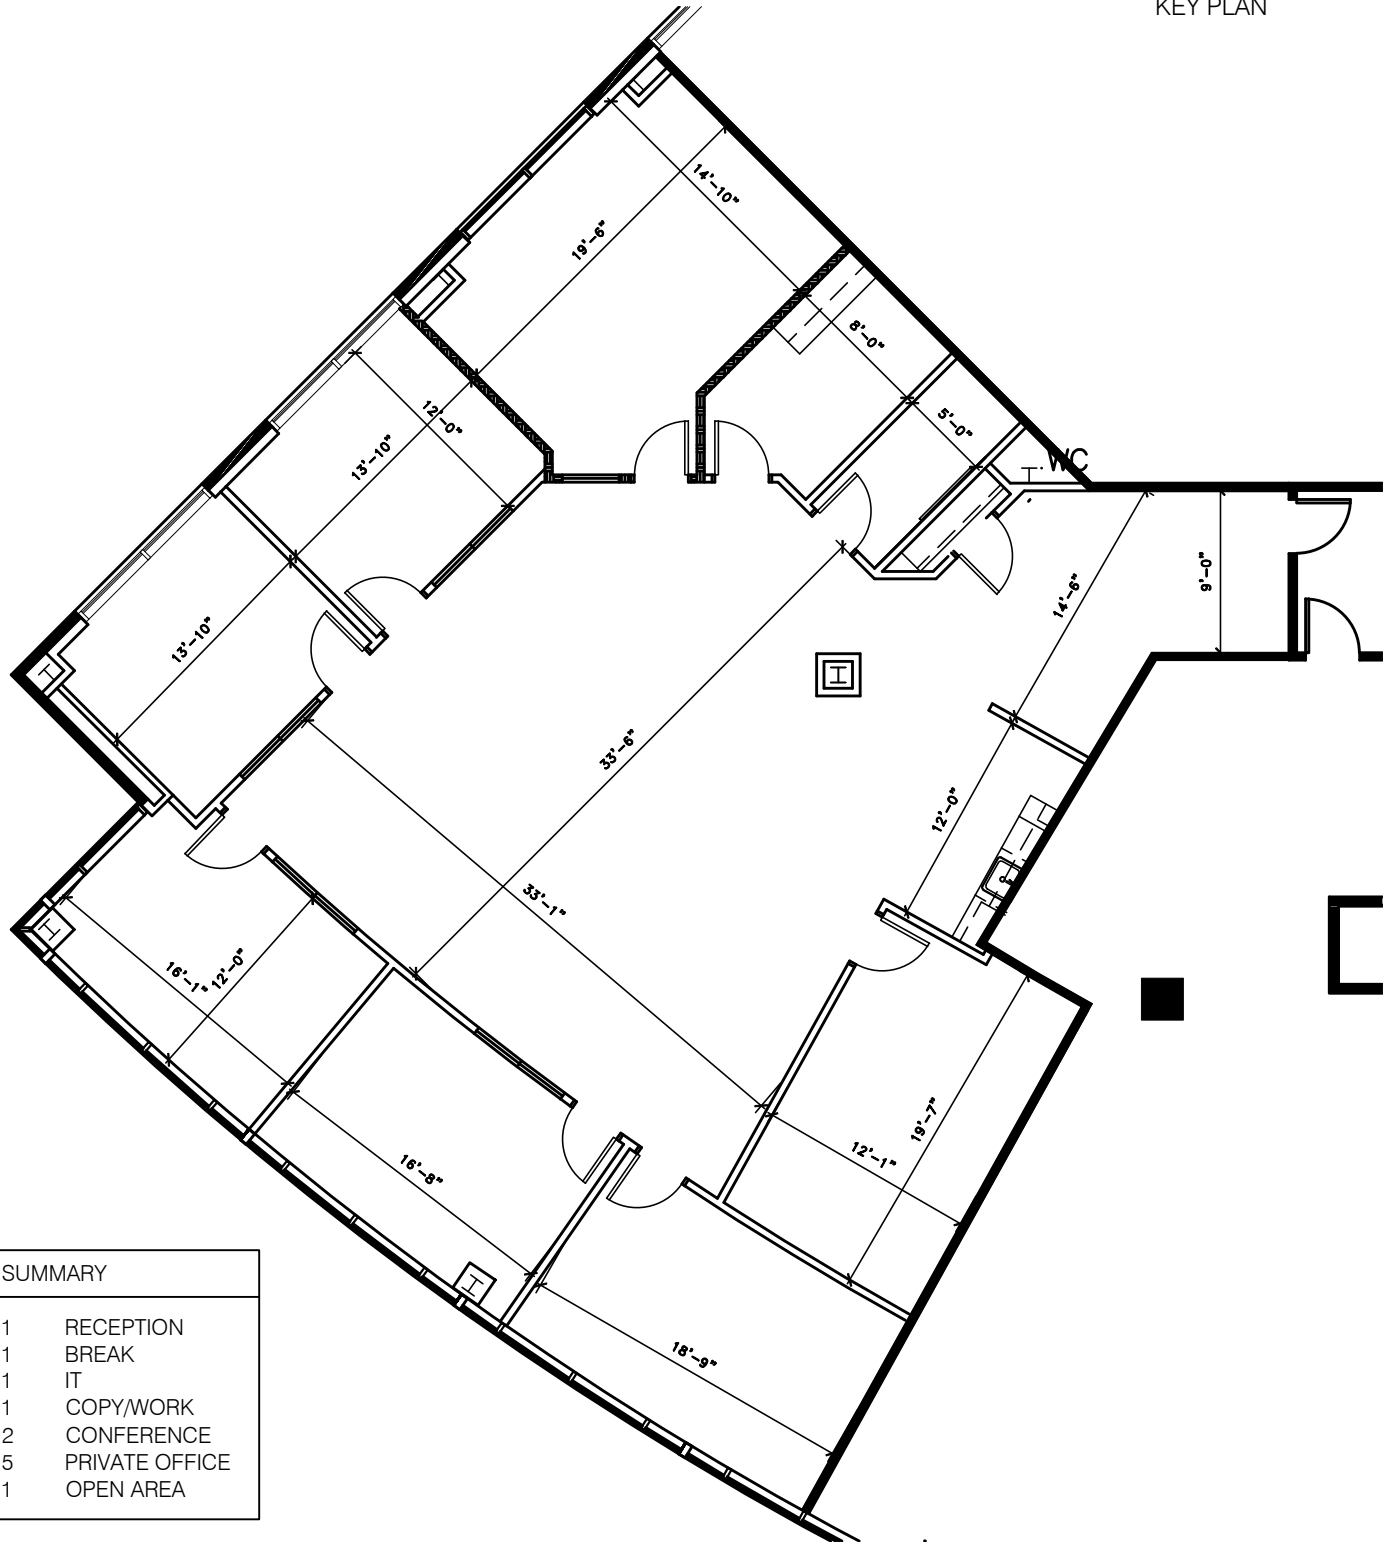

SUMMARY	
1	RECEPTION
1	BREAK
1	IT
1	COPY/WORK
2	CONFERENCE
5	PRIVATE OFFICE
1	OPEN AREA

