
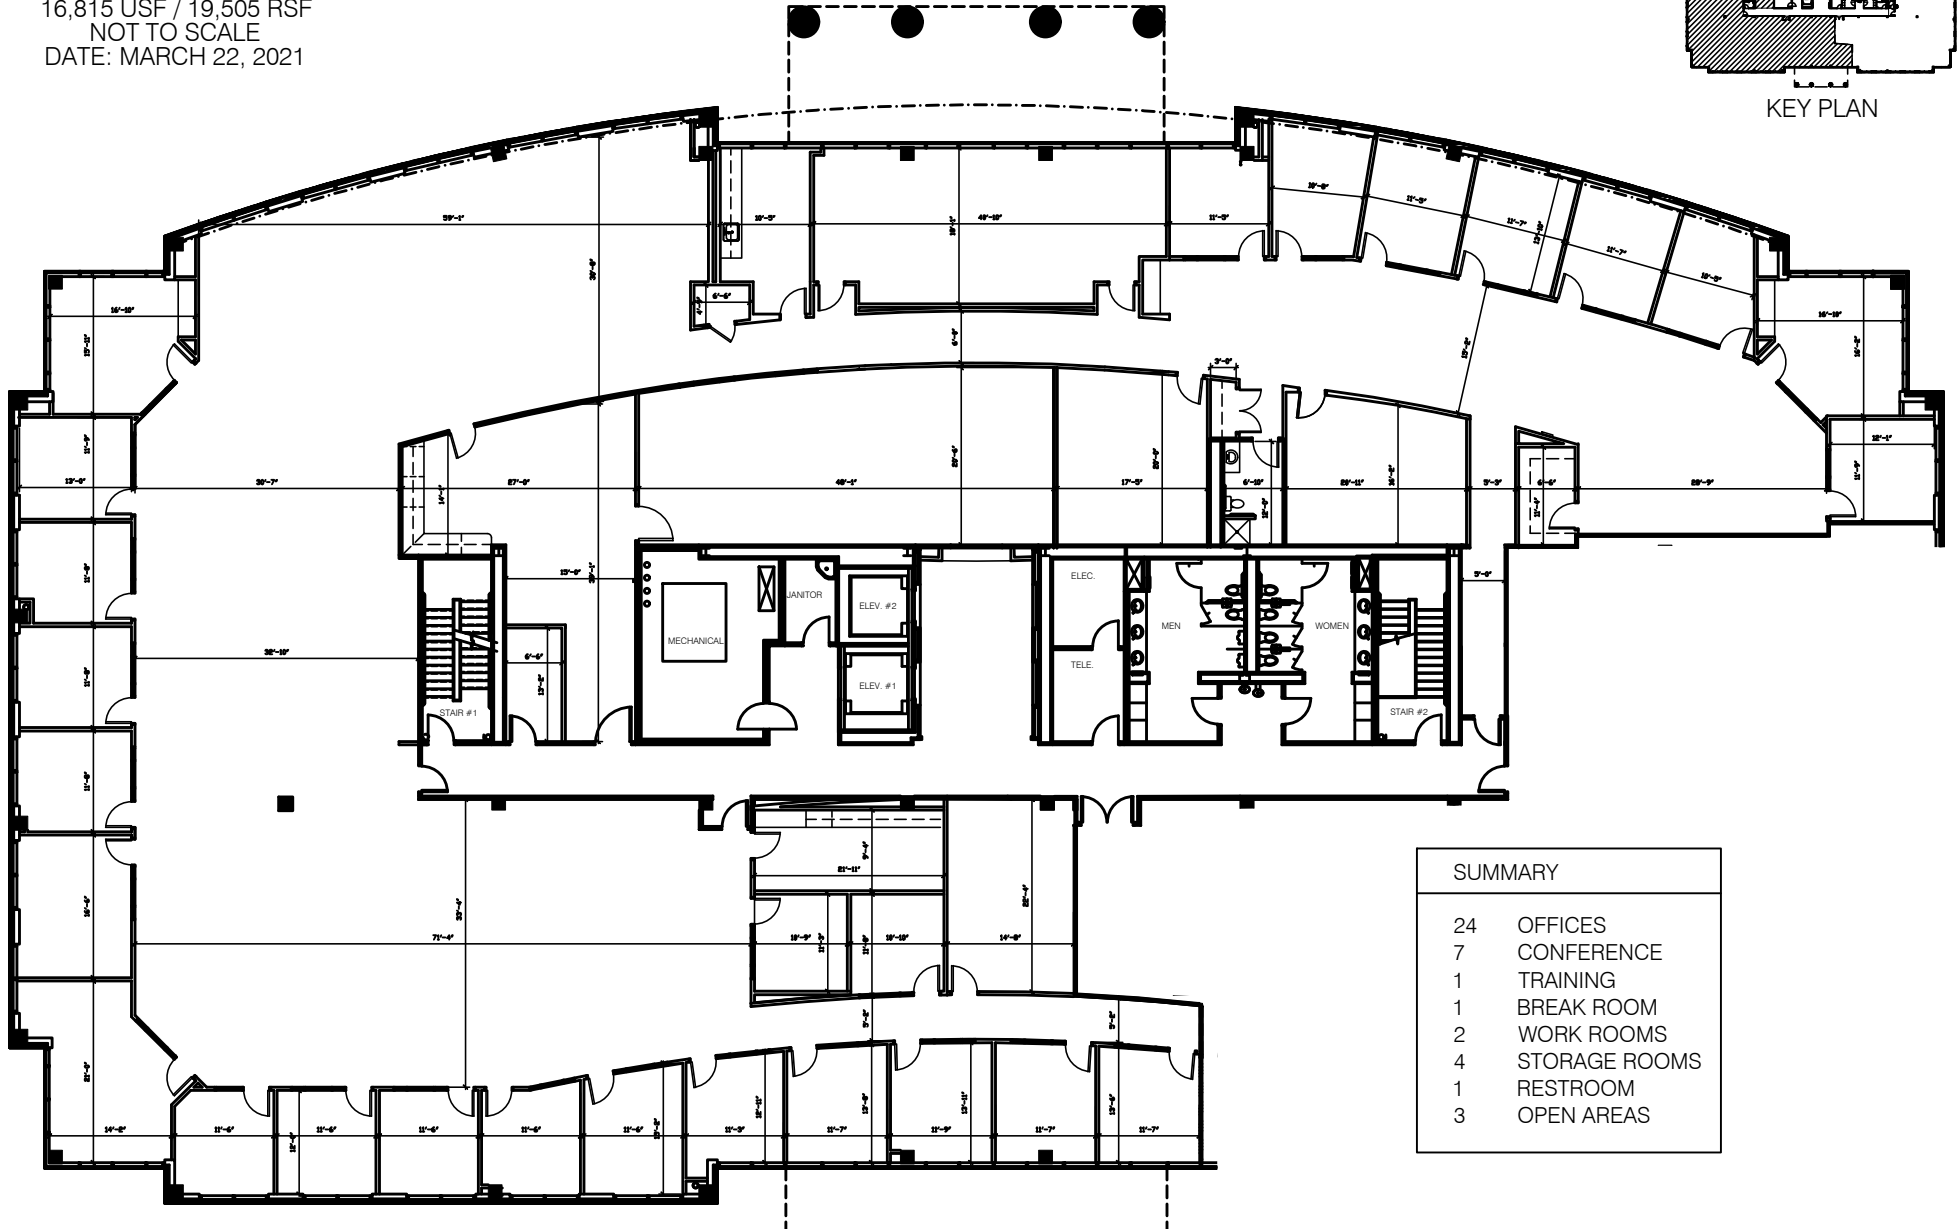


SUITE 400
 AS BUILT - 1 OF 1
 SIMMONS BUILDING - LEVEL FOUR
 16,815 USF / 19,505 RSF
 NOT TO SCALE
 DATE: MARCH 22, 2021

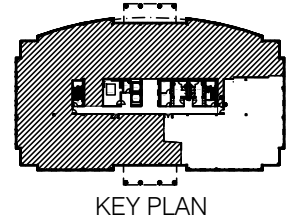

SUMMARY	
24	OFFICES
7	CONFERENCE
1	TRAINING
1	BREAK ROOM
2	WORK ROOMS
4	STORAGE ROOMS
1	RESTROOM
3	OPEN AREAS