


Simmons Building

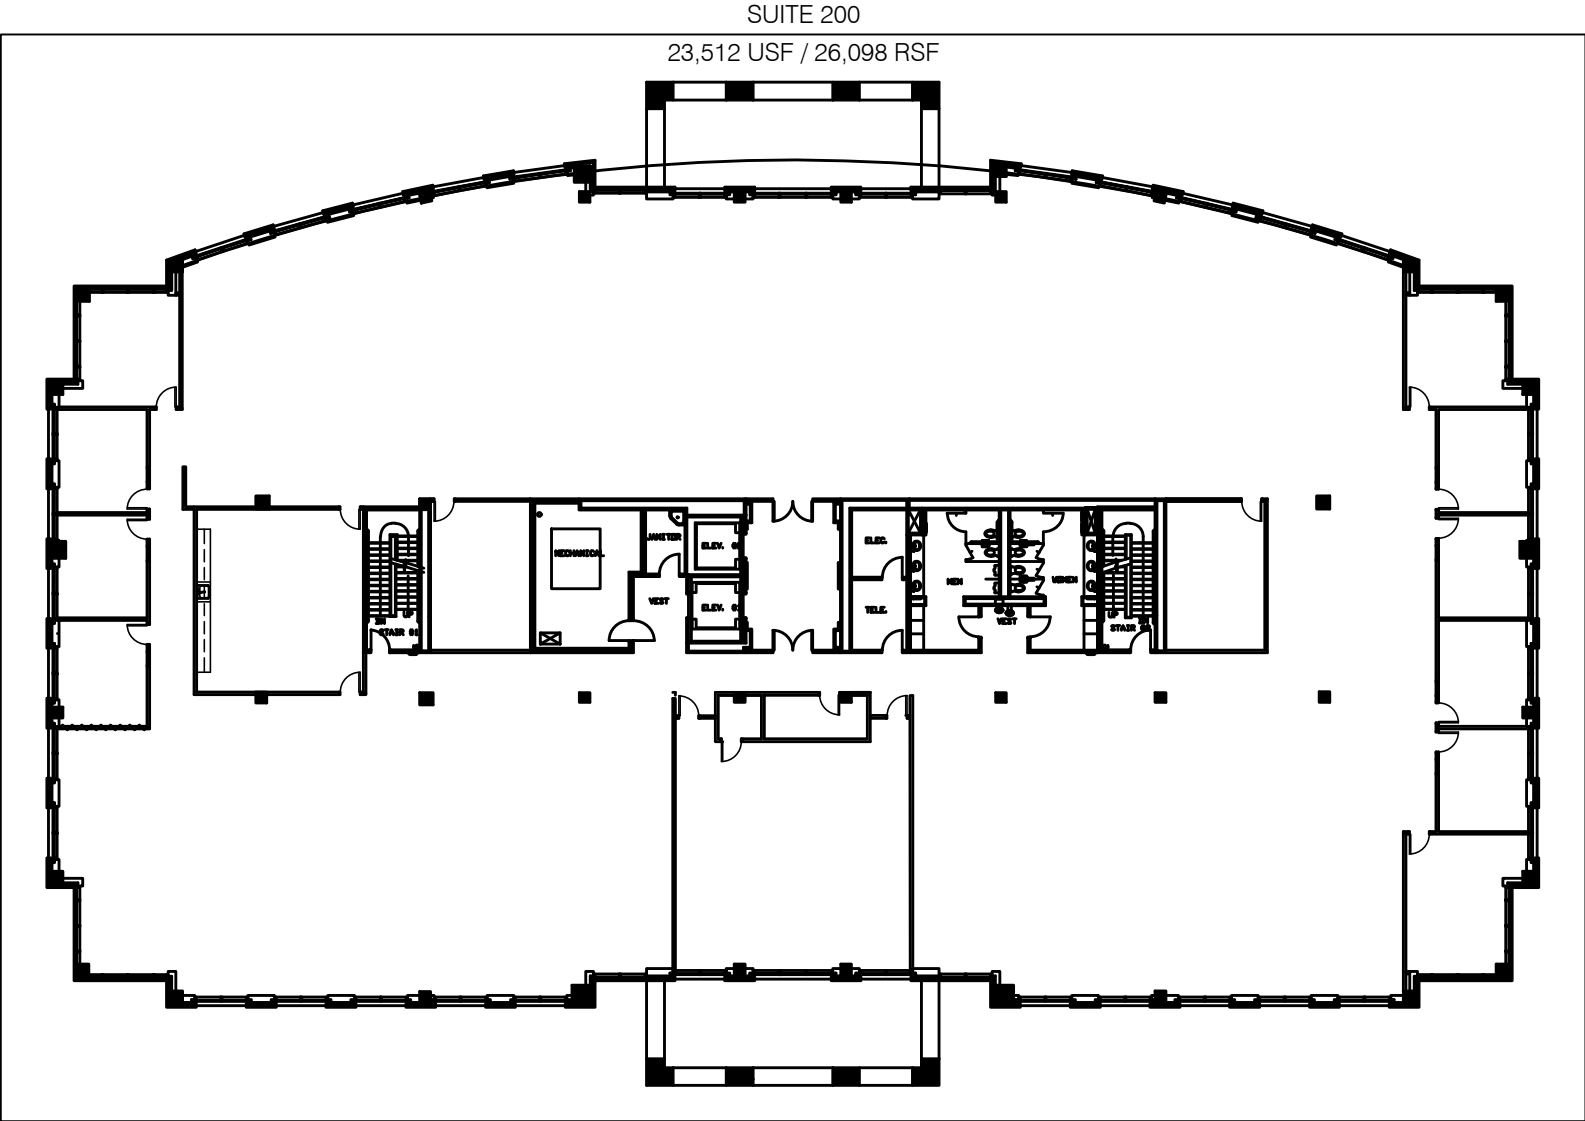

13840 Ballantyne Corporate Place

CBP-1J

Level Two

As Built

4/21/2021

Not to Scale

NORTHWOOD
OFFICE



**SMITH
HARRIS**
DESIGN
associates