



SUITE 100
AS BUILT - 1 OF 1
CULLMAN PARK - LEVEL ONE
13,314 USF / 15,444 RSF
NOT TO SCALE
DATE: JUNE 19, 2020

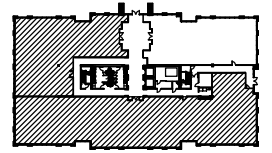

KEY PLAN

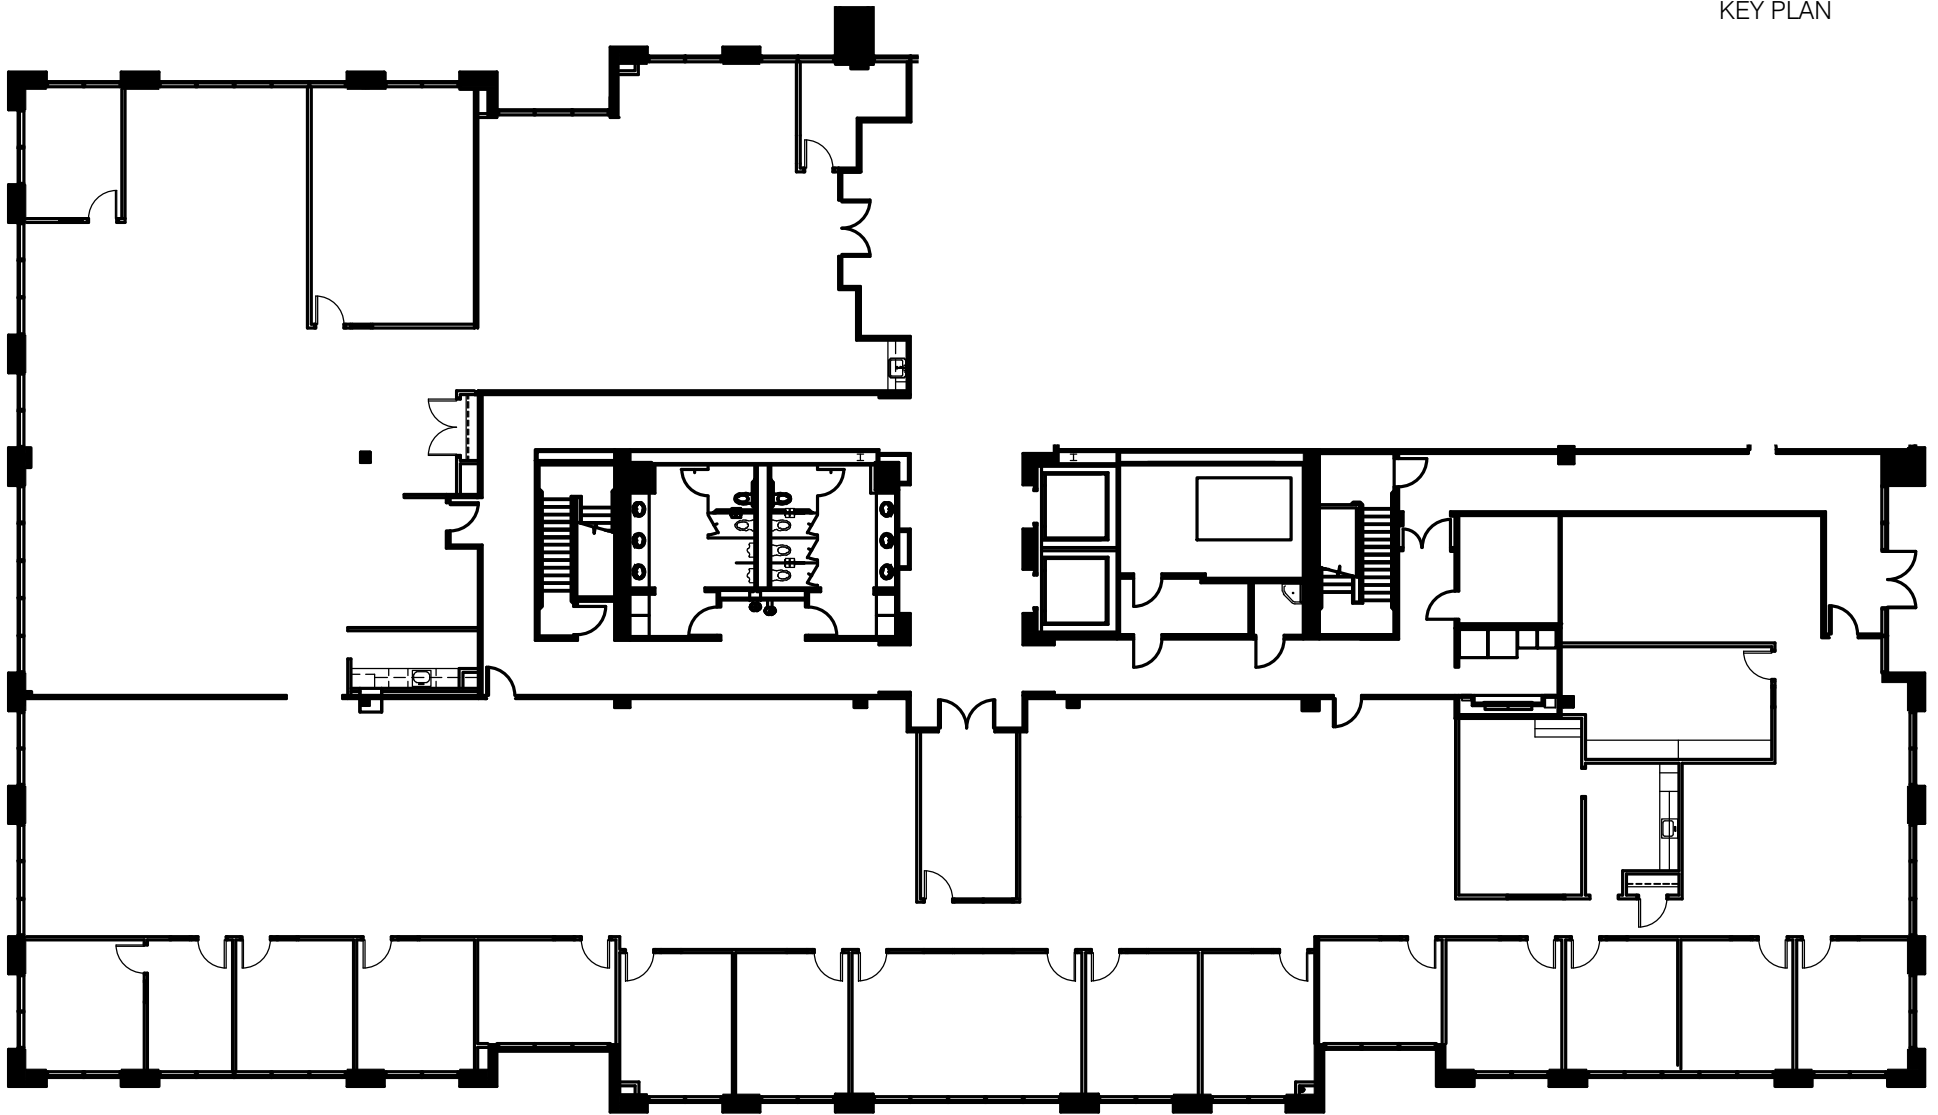

NORTHWOOD
OFFICE



**SMITH
HARRIS**
DESIGN
associates