

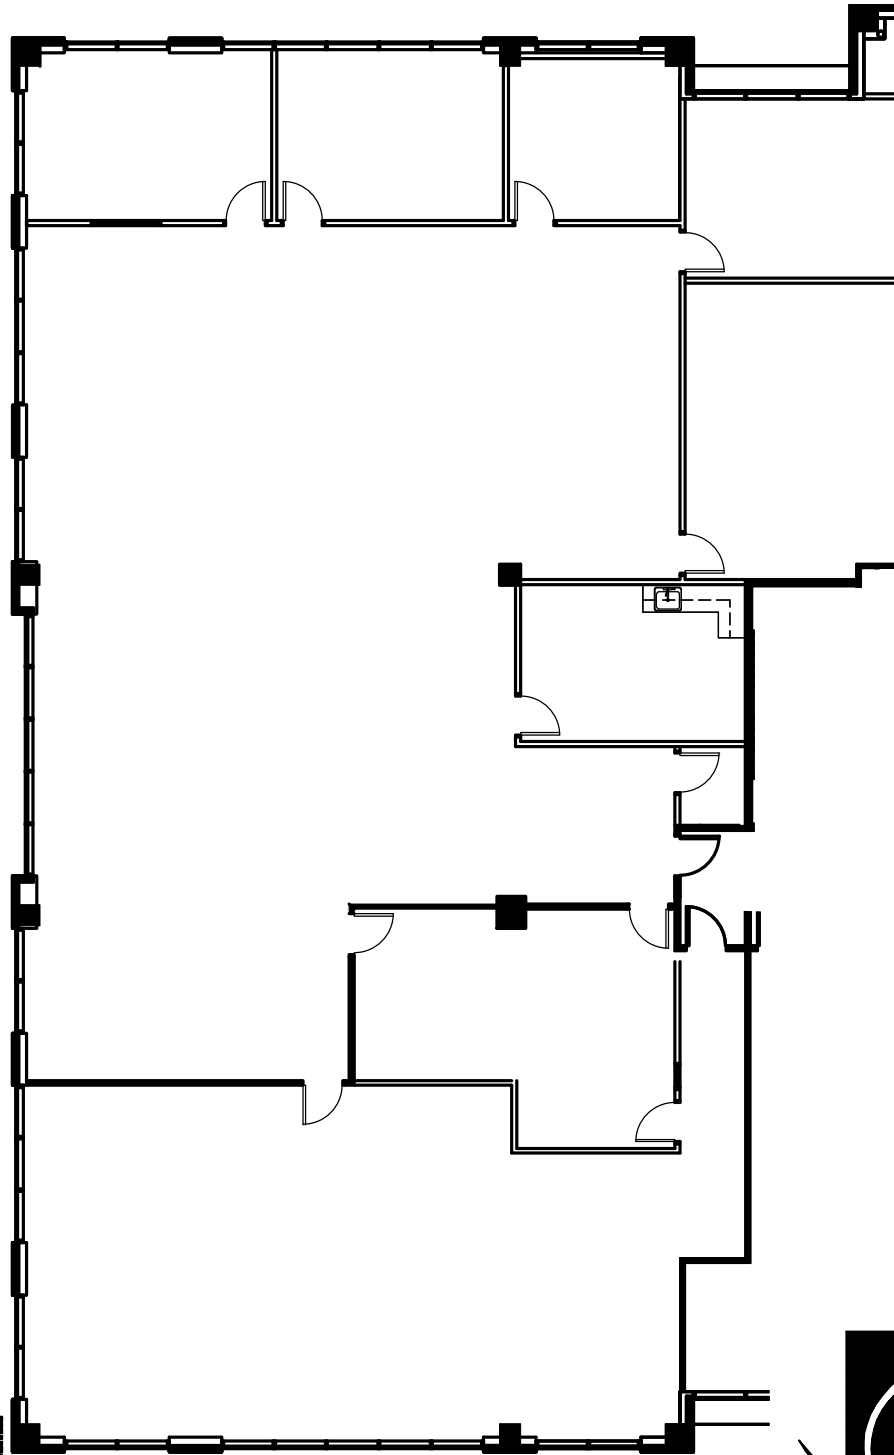


SUITE 375
AS BUILT - 1 OF 1
CULLMAN PARK - LEVEL THREE
6,227 USF / 7,223 RSF
NOT TO SCALE
DATE: SEPTEMBER 18, 2020

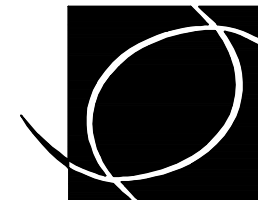

KEY PLAN

NORTHWOOD
OFFICE

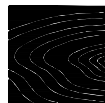

**SMITH
HARRIS**
DESIGN
associates