



SUITE 125  
 AS BUILT - 1 OF 1  
 SIMMONS BUILDING - LEVEL ONE  
 3,996 USF / 4,635 RSF  
 SCALE: 3/32" = 1'-0"  
 DATE: JULY 6, 2021

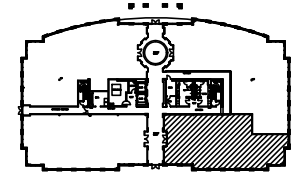

KEY PLAN

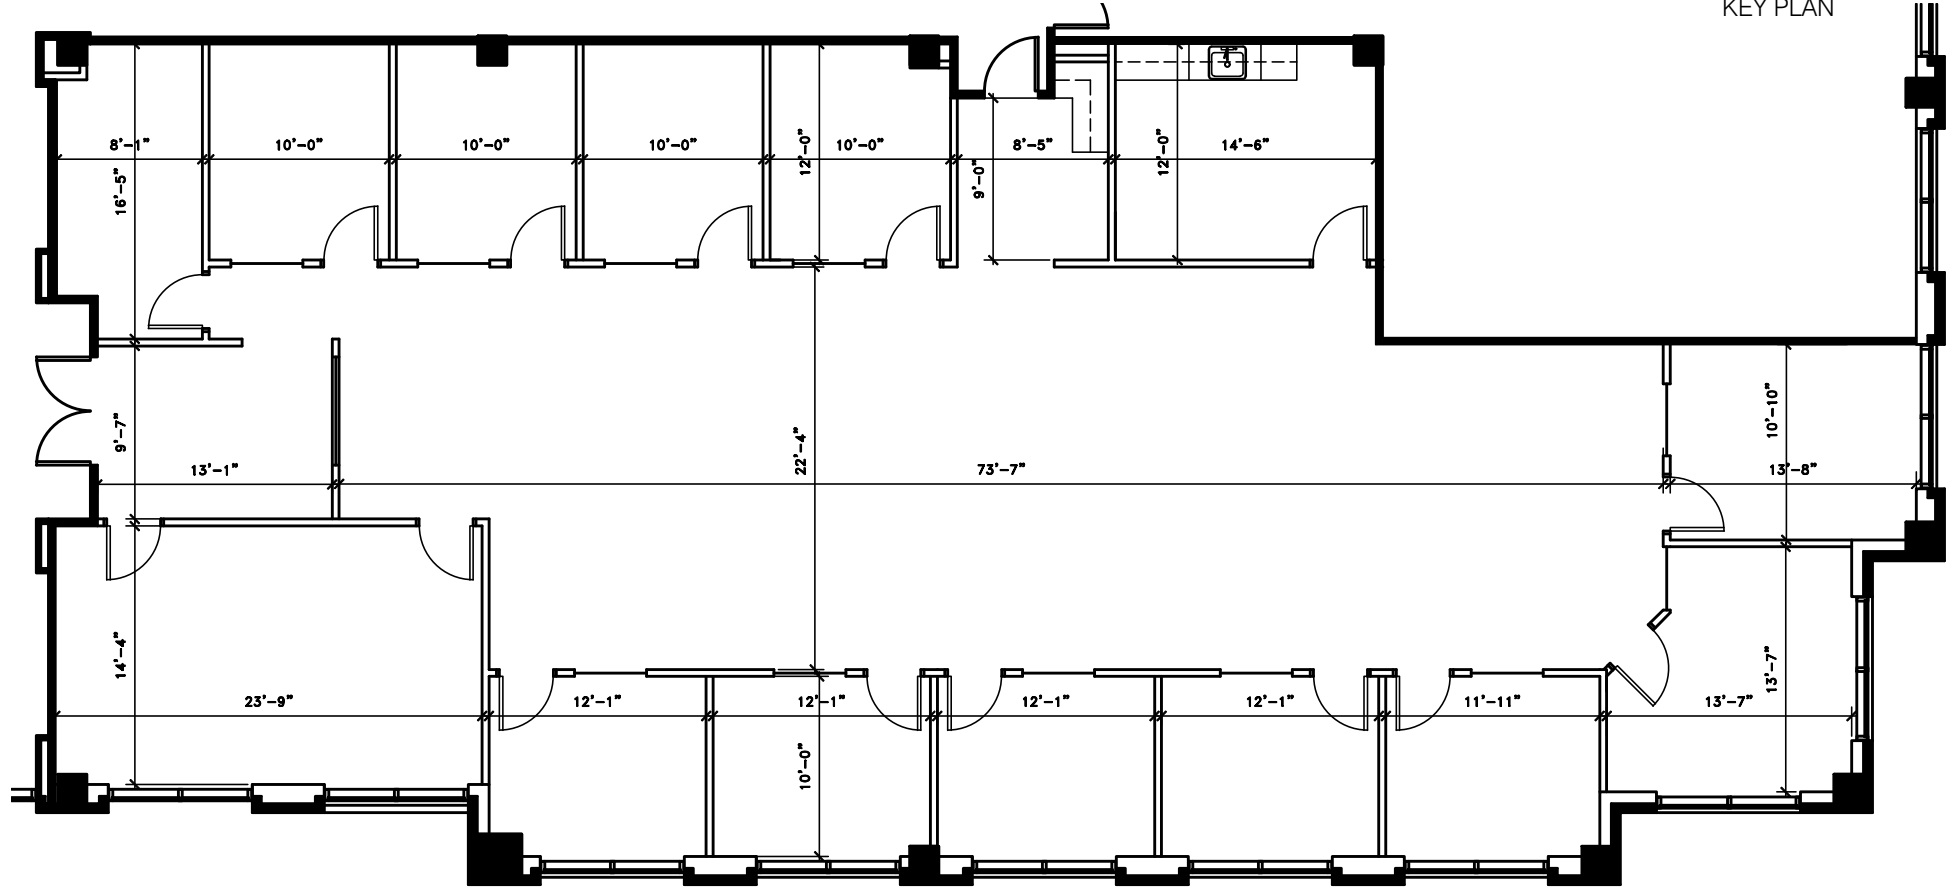

SUMMARY	
1	ENTRY
1	CONFERENCE
1	IT ROOM
1	OPEN AREA
11	PRIVATE OFFICE
1	BREAK ROOM
1	COPY AREA