



SUITE 100
 AS BUILT - 1 OF 1
 IRBY BUILDING - LEVEL ONE
 7,393 USF / 8,576 RSF
 SCALE: 1/16" = 1'-0"
 DATE: JUNE 14, 2021

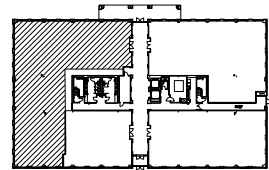

KEY PLAN

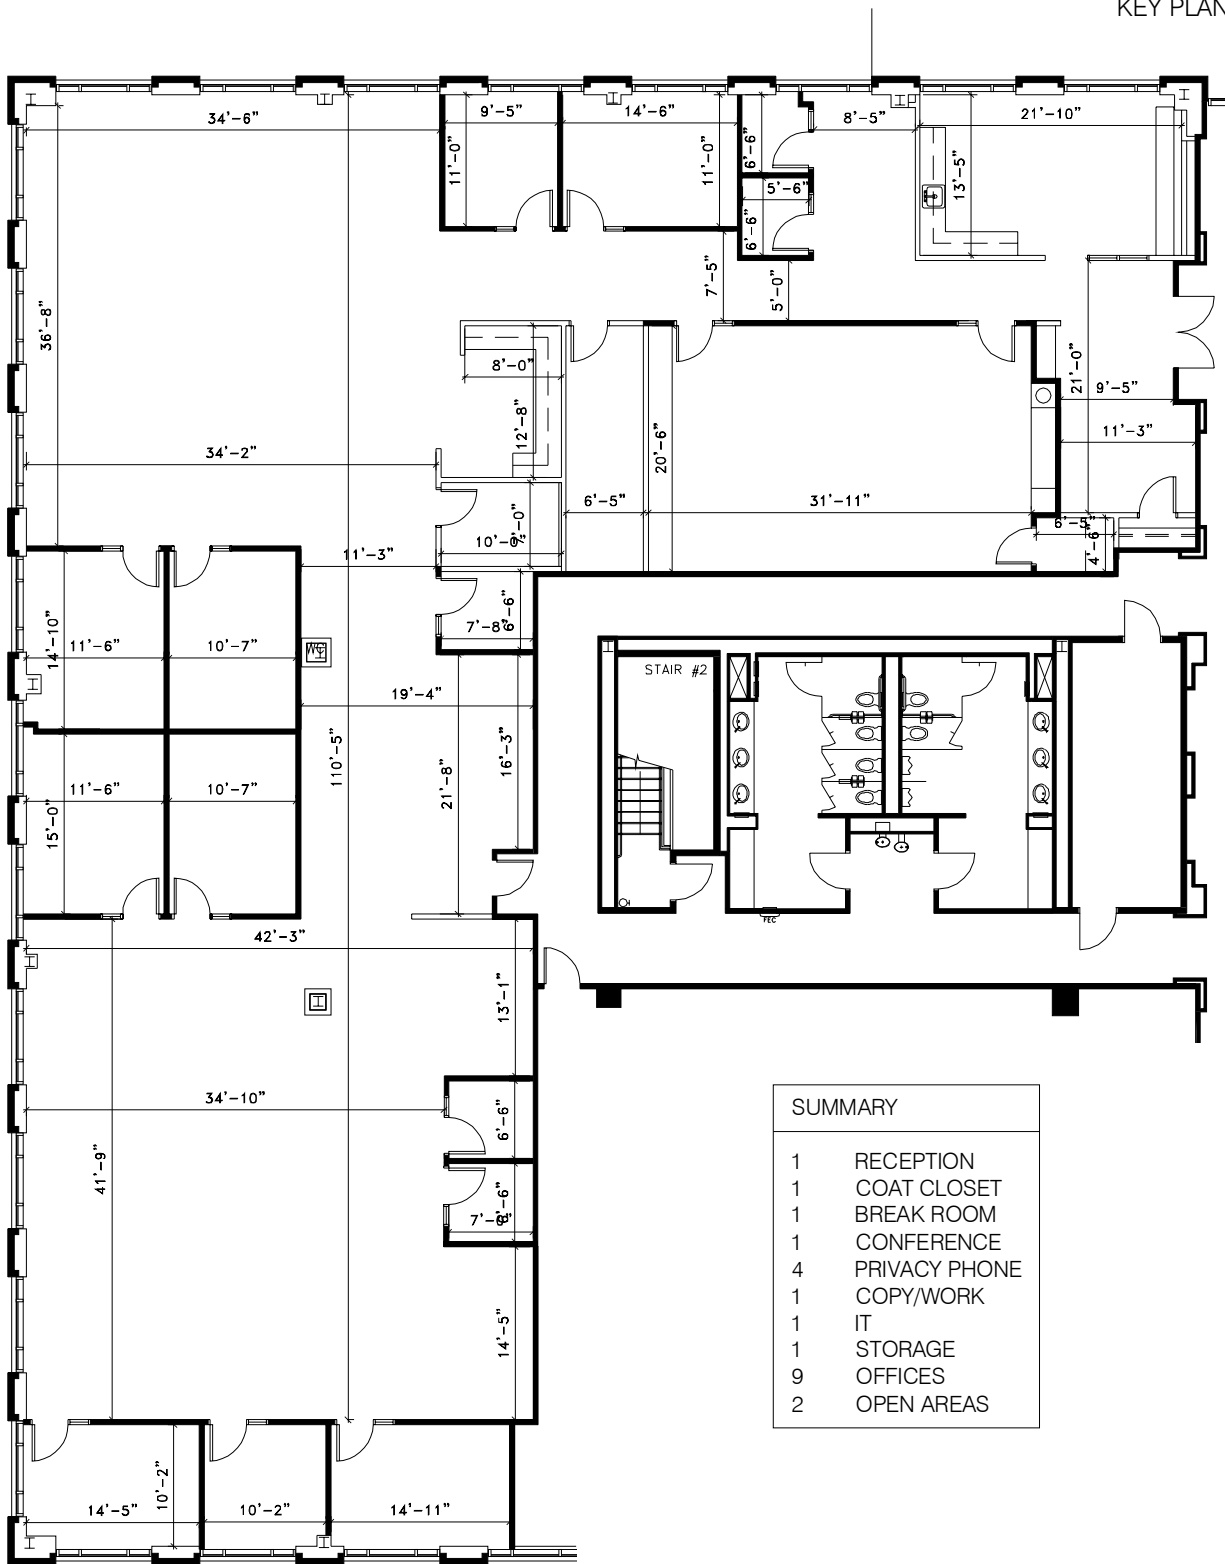

SUMMARY	
1	RECEPTION
1	COAT CLOSET
1	BREAK ROOM
1	CONFERENCE
4	PRIVACY PHONE
1	COPY/WORK
1	IT
1	STORAGE
9	OFFICES
2	OPEN AREAS