


SUMMARY			
1	ENTRY	2	PHONE ROOMS
2	CONFERENCE	1	STORAGE
2	COPY ROOM	3	OPEN AREAS
1	BREAK AREA		

Hixon Building

SUITE 300
25,147 USF / 27,913 RSF

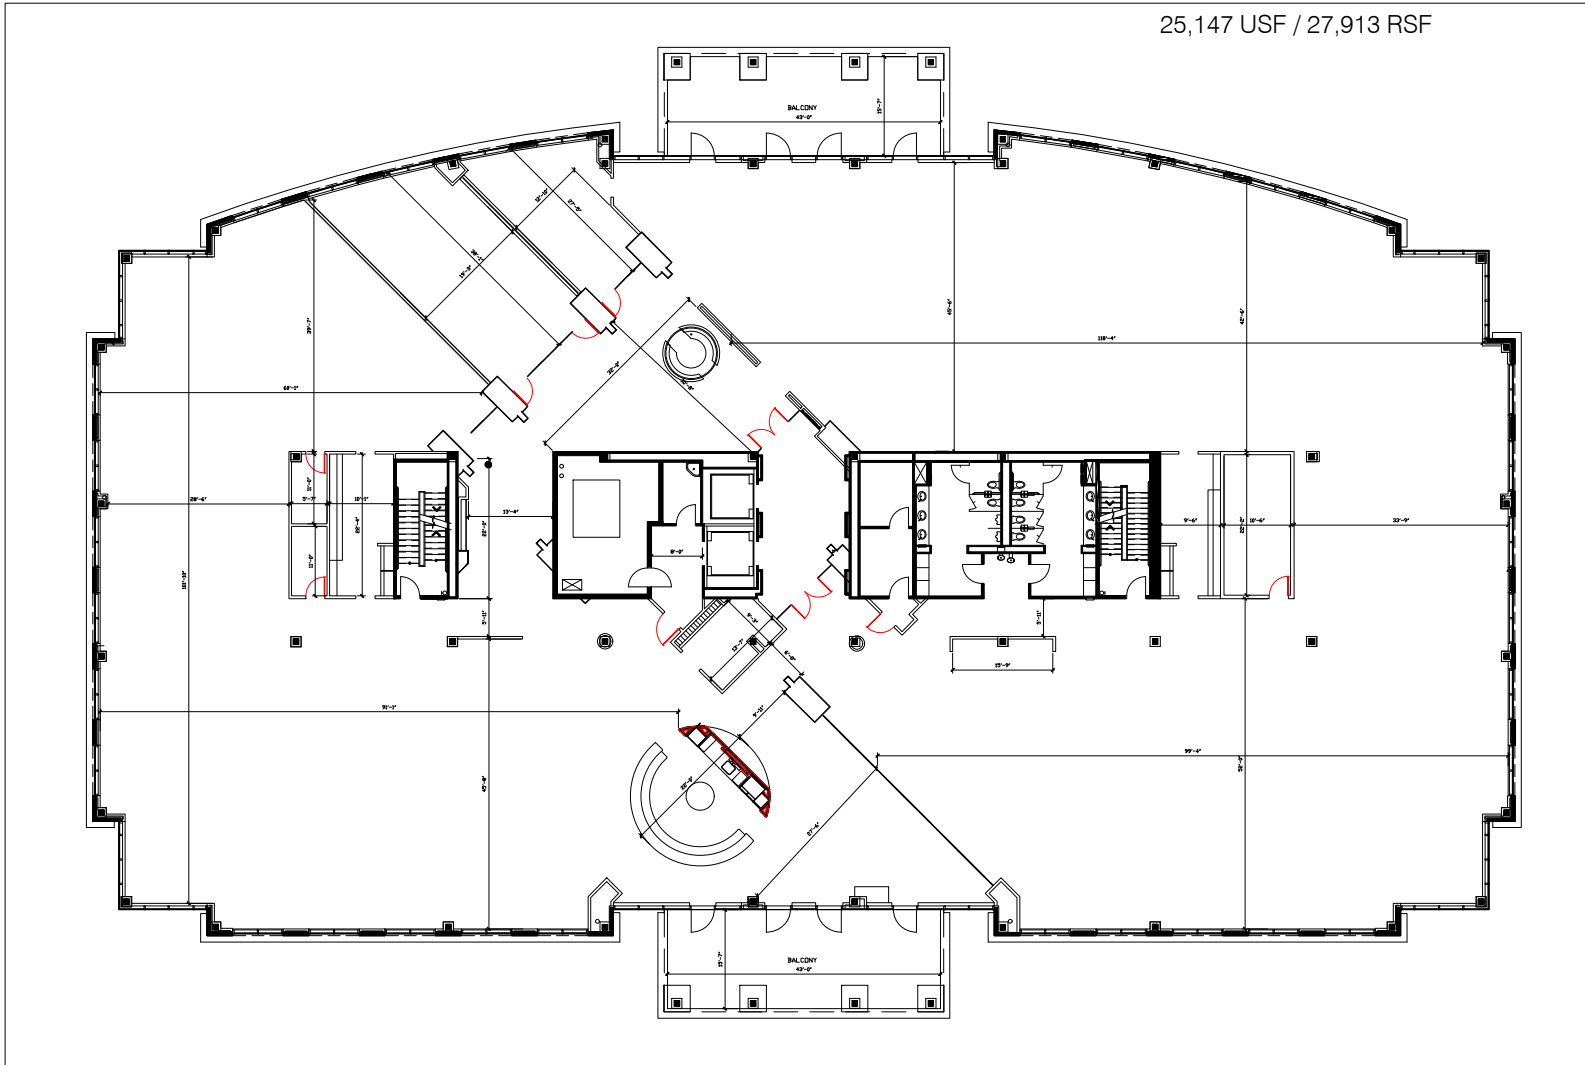

13850 Ballantyne Corporate Place


Level Three

As Built

5/4/2021

Not to Scale

NORTHWOOD
OFFICE


**SMITH
HARRIS**
DESIGN
associates