

Harris Building

13024 Ballantyne Corporate Place


Level Four

As Built


08/11/2021

Not to Scale

NORTHWOOD
OFFICE

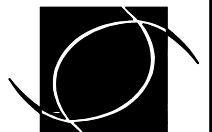

**SMITH
HARRIS**
DESIGN
associates

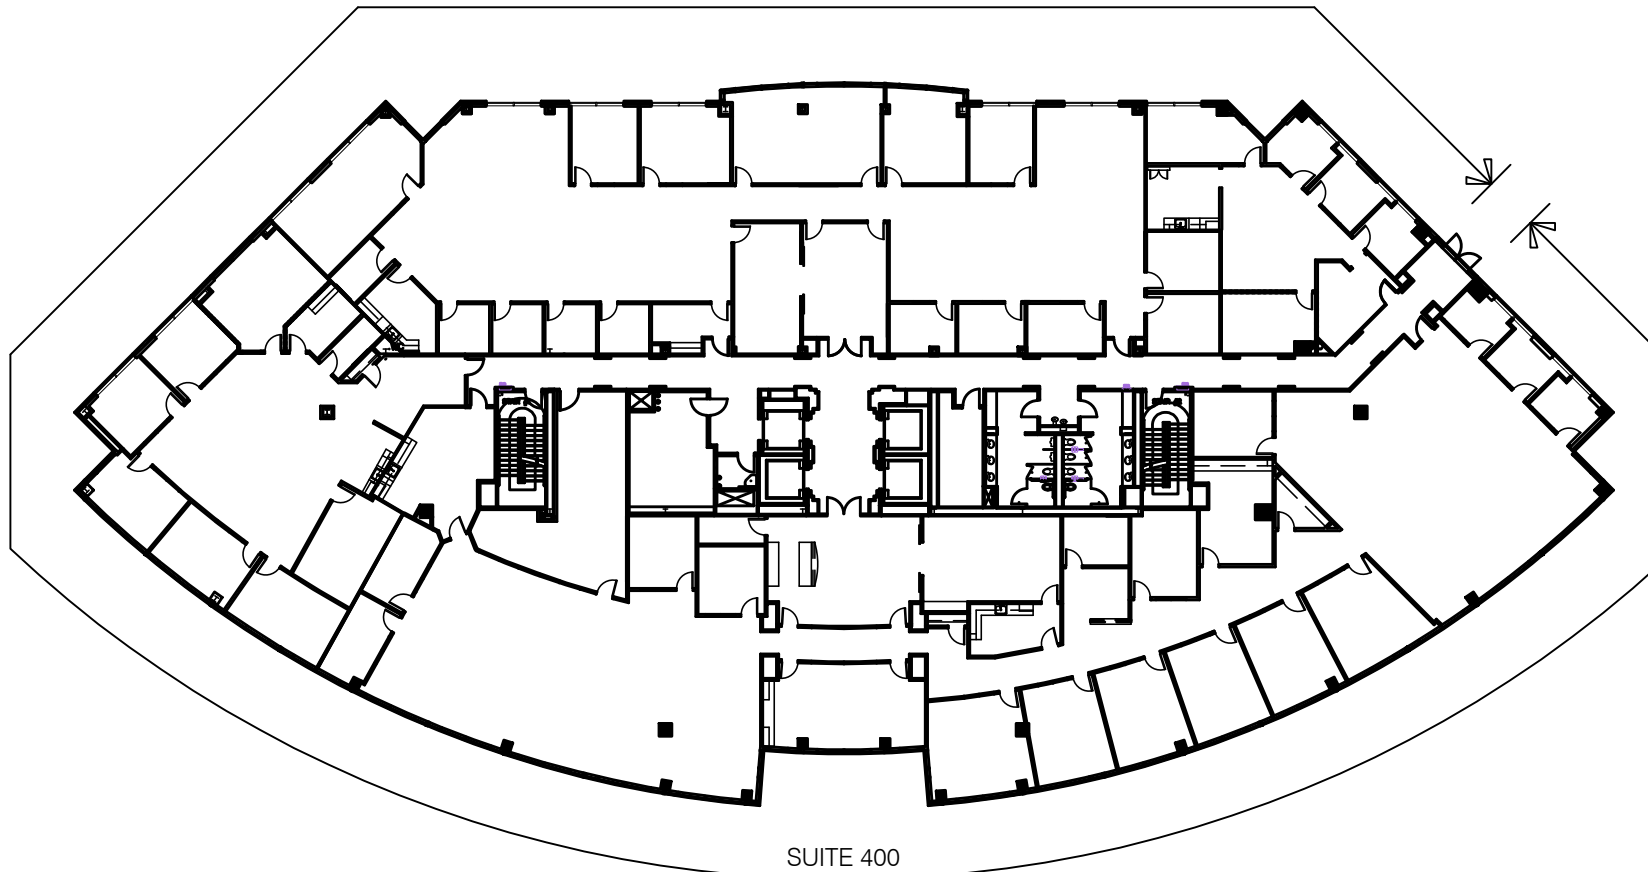

SUITE 400
23,205 USF / 26,918 RSF