


SUITE 400
 AS BUILT - 1 OF 1
 HARRIS - LEVEL FOUR
 11,440 USF/13,270 RSF
 NOT TO SCALE
 DATE: JULY 9, 2021



SUMMARY	
1	RECEPTION
3	CONFERENCE
2	BREAK ROOM
1	LARGE WORK/STORAGE
16	PRIVATE OFFICE
2	OPEN AREA
1	IT
1	STORAGE

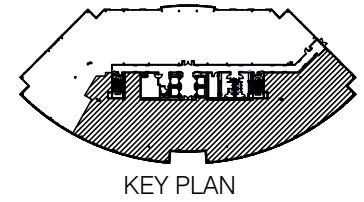