



SUITE 400  
 AS BUILT - 1 OF 1  
 HIXON BUILDING - LEVEL FOUR  
 11,750 USF / 13,630 RSF  
 NOT TO SCALE  
 DATE: MAY 4, 2021

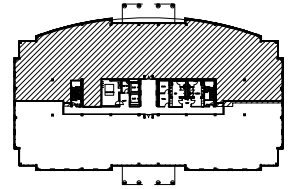

KEY PLAN

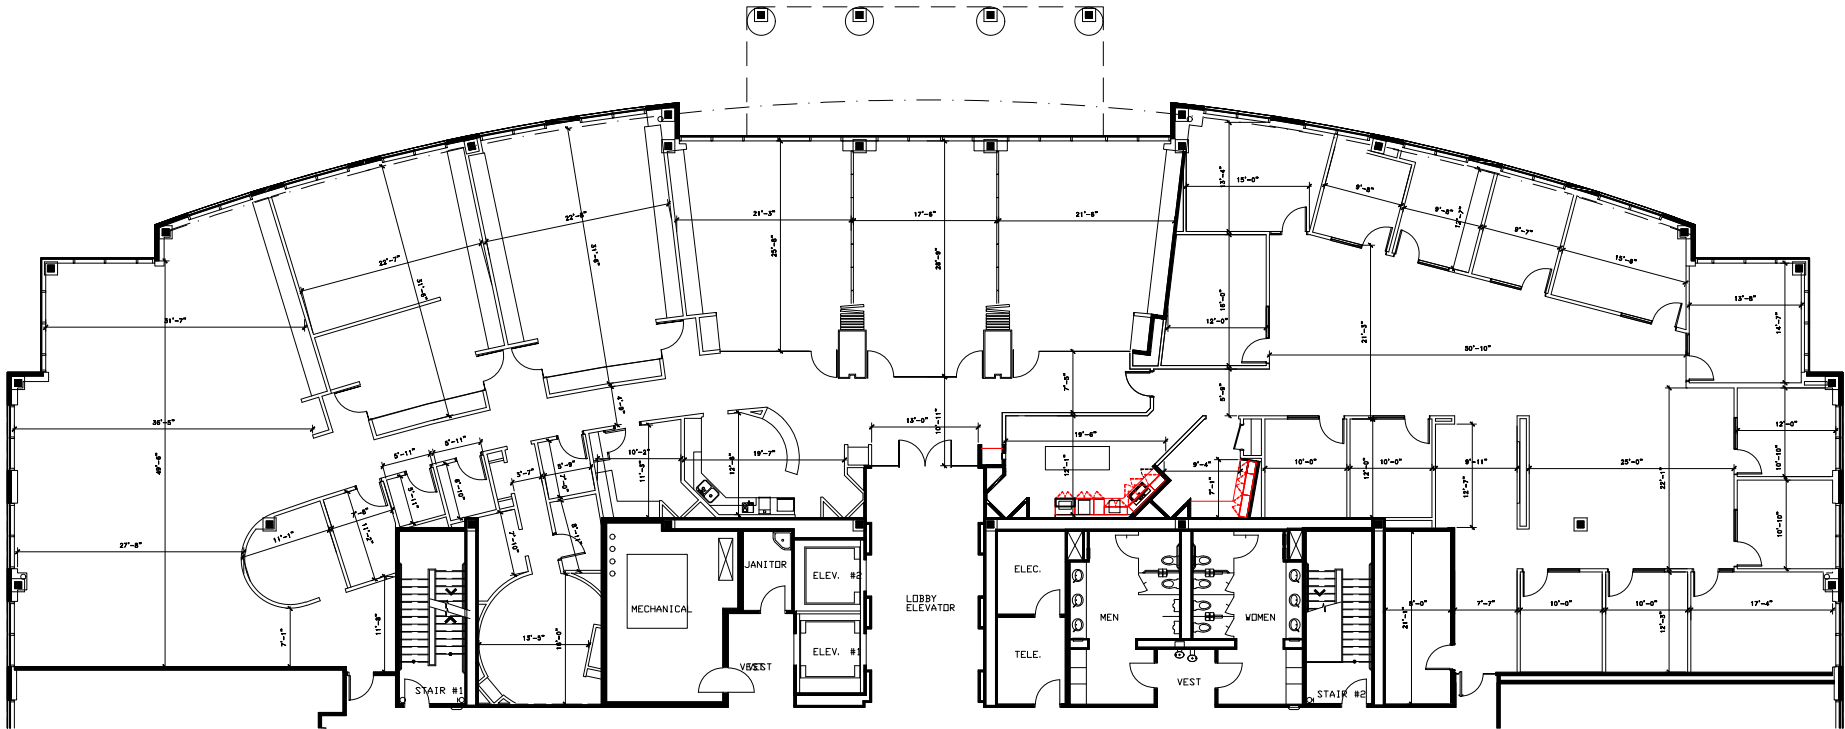

SUMMARY	
1	ENTRY
5	CONFERENCE
14	PRIVATE OFFICE
2	BREAK ROOMS
2	COPY ROOMS
2	IT/STORAGE
2	COLLABORATION
5	PHONE ROOMS
2	OPEN AREAS