



SUITE 275  
AS BUILT PLAN - 1 OF 1  
HALL - LEVEL TWO  
6,916 USF / 8,023 RSF  
SCALE: 1/16" = 1'-0"  
DATE: DECEMBER 17, 2021

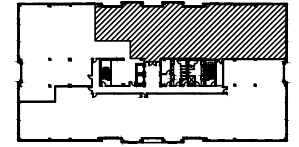

KEY PLAN

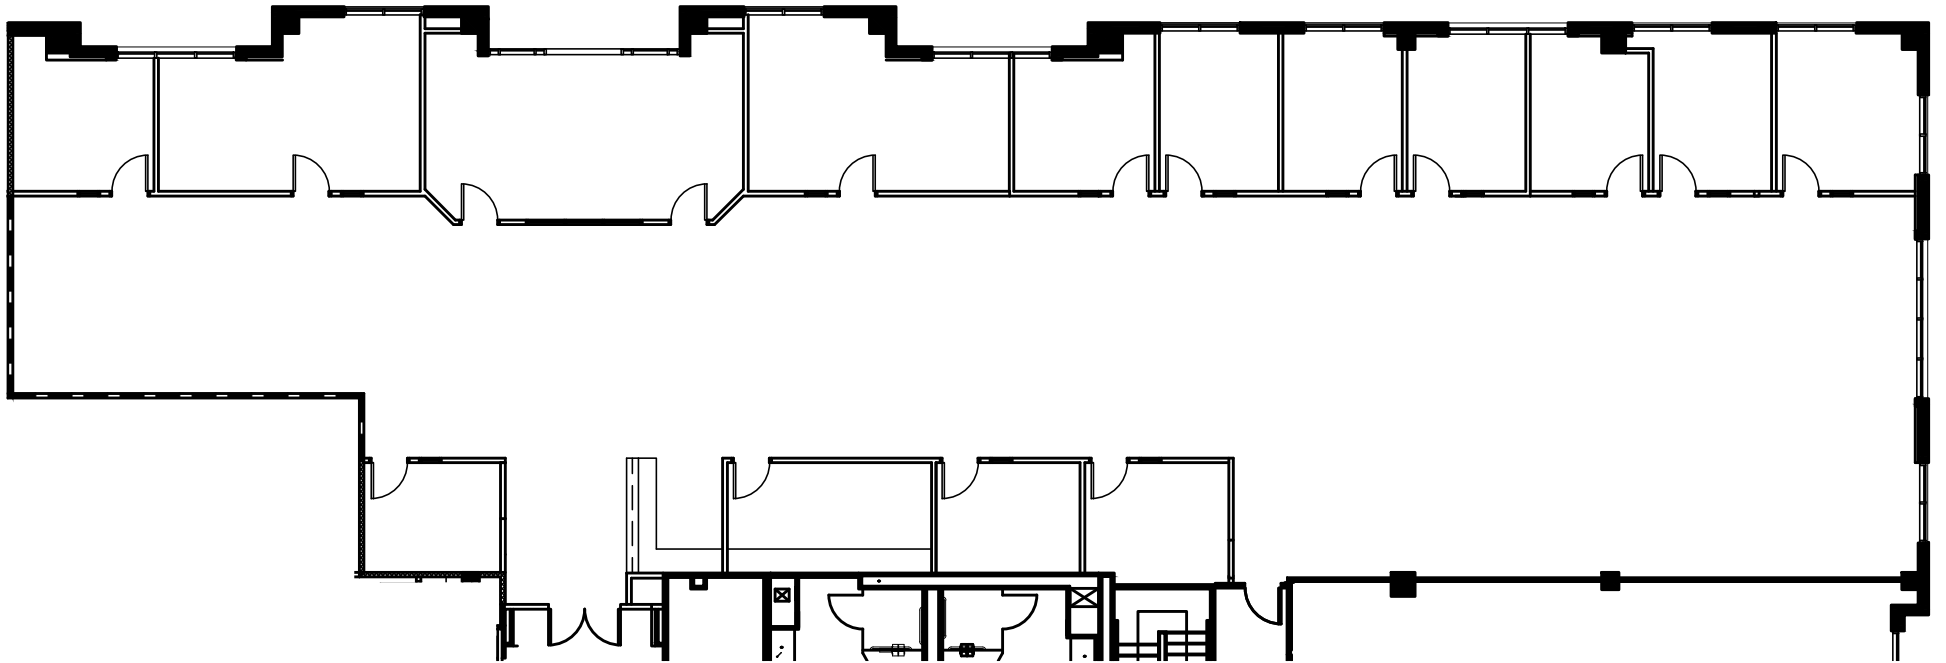

**NORTHWOOD**  
OFFICE

