


SUITE 100  
AS BUILT - 1 OF 1  
OVERLOOK BUILDING - LEVEL ONE  
5,116 USF / 6,011 RSF  
NOT TO SCALE  
DATE: OCTOBER 5, 2021



KEY PLAN

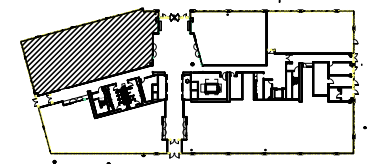