


SUITE 175  
AS BUILT - 1 OF 1  
OVERLOOK BUILDING - LEVEL ONE  
4,004 USF / 4,705 RSF  
SCALE: 1/16" = 1'-0"  
DATE: OCTOBER 14, 2021

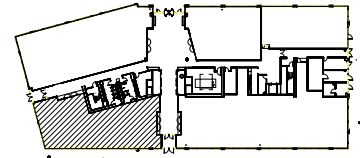

KEY PLAN

