



SUITE 115  
AS BUILT - 1 OF 1  
OVERLOOK BUILDING - LEVEL ONE  
2,103 USF / 2,471 RSF  
SCALE: 1/8" = 1'-0"

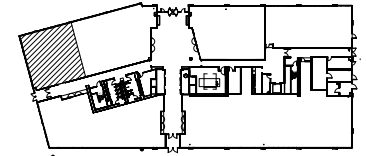

KEY PLAN

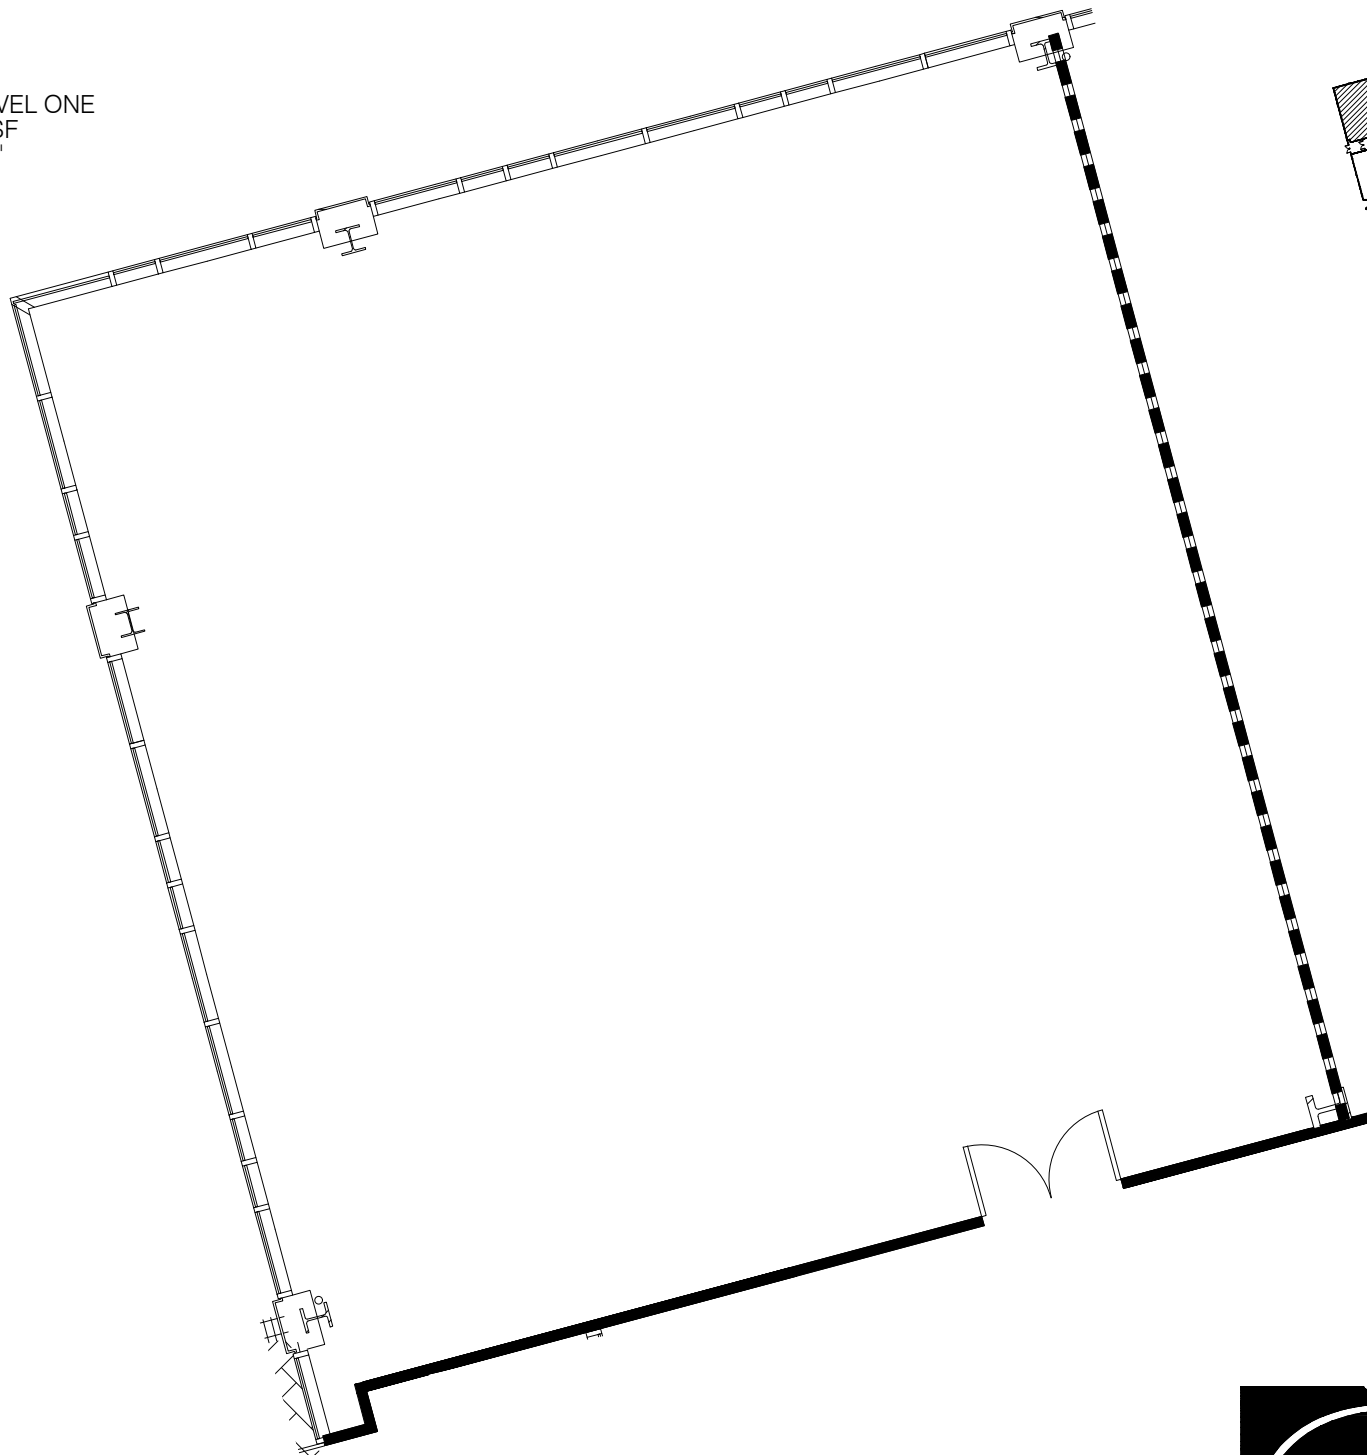

**NORTHWOOD**  
OFFICE



**SMITH  
HARRIS**  
**DESIGN**  
associates