SUITE 100

AS BUILT - 1 OF 1
BRIXHAM GREEN III - LEVEL ONE
4,020 USF / 4,623 RSF
NOT TO SCALE
DATE: MARCH 17, 2009

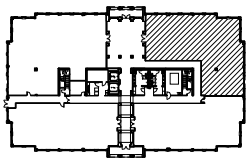

KEY PLAN

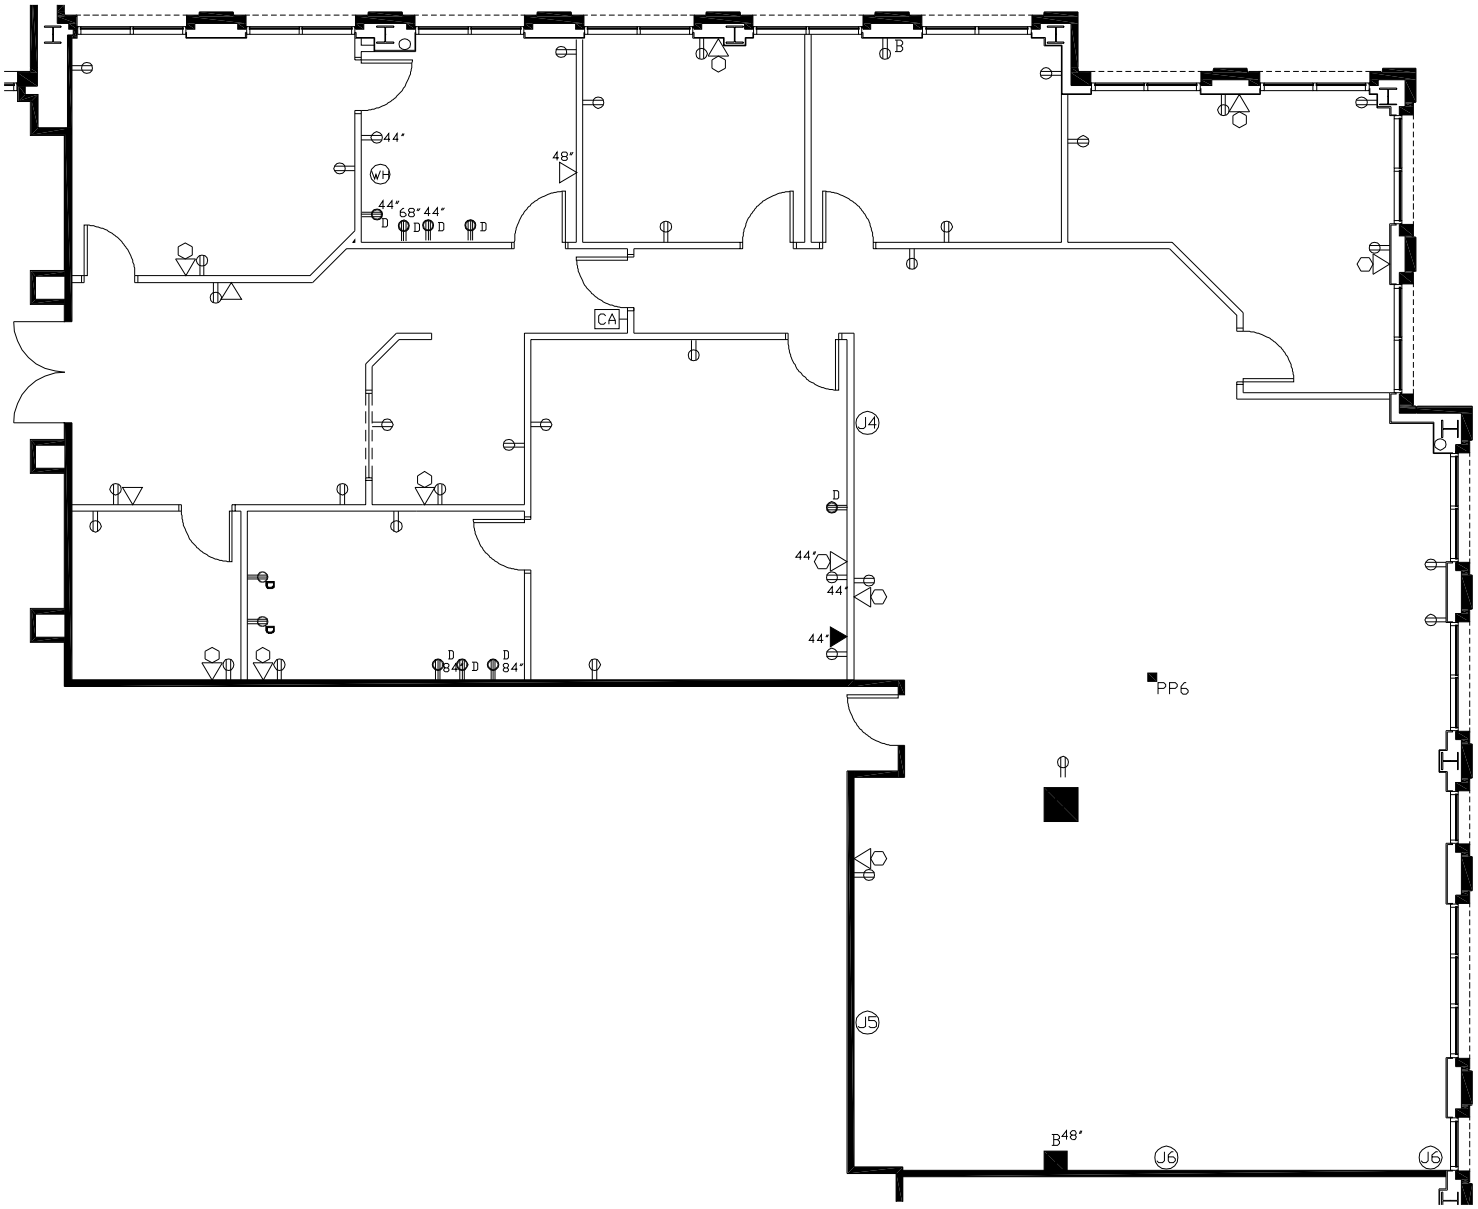

Bissell DEVELOPMENT

SMITH HARRIS DESIGN associates