SUITE 250

AS BUILT - 1 OF 1
GIBSON BUILDING - SUITE 250
3,371 USF / 3,910 RSF
SCALE: 3/32" = 1'-0"
DATE: OCTOBER 21, 2020

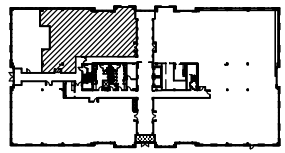

KEY PLAN

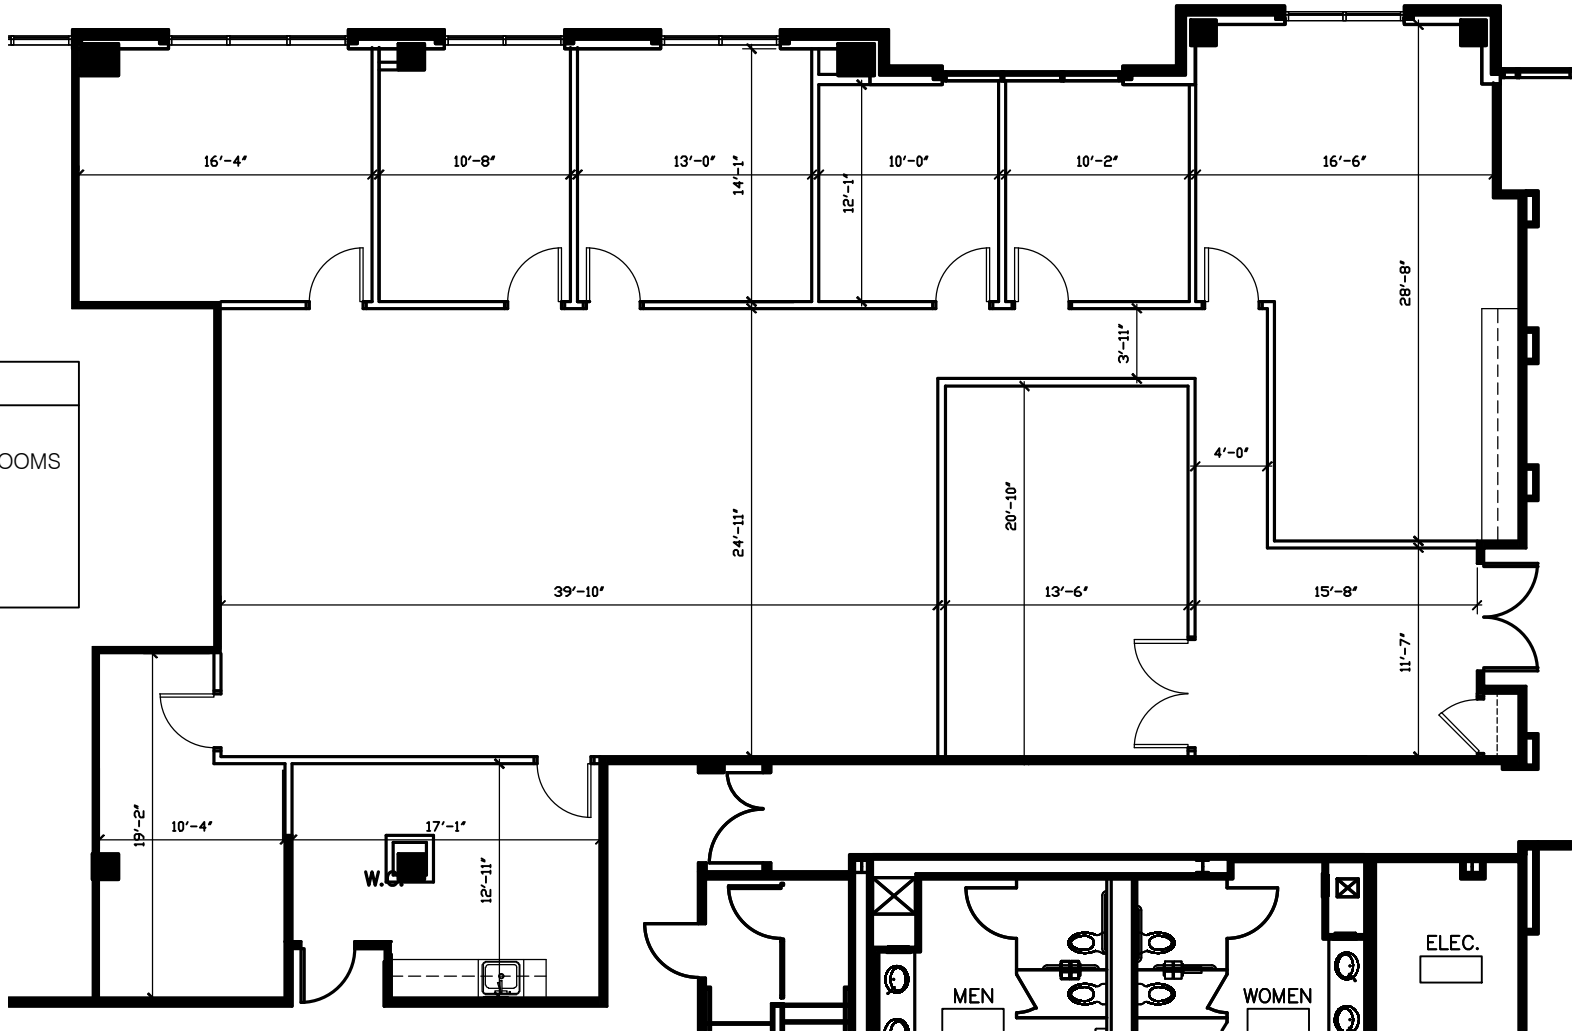

SUMMARY	
1	RECEPTION
2	CONFERENCE ROOMS
5	OFFICES
1	OPEN AREA
1	BREAK ROOM
1	IT/STORAGE

NORTHWOOD OFFICE

SMITH HARRIS DESIGN associates